

~~PLAT OF COMPUTATION~~
~~ON LOT 2, SQUARE S-5868, PARCEL 228/144 AND RESERVATION 519~~
~~SHOWING 33 THEORETICAL SITES~~

ST. ELIZABETH EAST CAMPUS - A&T LOT EXHIBIT

Office of the Surveyor, D.C.

November 30, 2012

I certify that the plat shown herein is correct and is recorded


**A&T LOT AREA
TABULATION**

A&T LOT	AREA-SQ.FT.
LOT 803	585,589
LOT 804	143,865
LOT 805	1,626,729
LOT 810	186,769
LOT 813	479,132
LOT 814	141,945
LOT 820	360,861
LOT 822	118,021
LOT 827	28,878
LOT 828	92,253
LOT 829	101,073
LOT 831	292,800
LOT 832	4,613
LOT 838	139,006
LOT 839	39,534
LOT 842	55,978
LOT 844	16,221
LOT 846	38,563
LOT 850	138,162
LOT 852	9,313
LOT 853	76,682
LOT 854	170
LOT 855	61
LOT 856	163,848
LOT 857	93
LOT 858	207,402
LOT 859	436,048
LOT 860	102,625
LOT 861	73,127
LOT 862	53,968
LOT 863	196,480
LOT 864	10,755
LOT 866	180,204
LOT 967	53,851
LOT 968	202,758

EXHIBIT SHOWING CURRENT LOTS AS OF JANUARY 14, 2022 WITHIN FORMER LOT 2, SQUARE S-5868 AND FORMER PARCEL 228/144 OUTSIDE LOT 2 ON PROPERTY PREVIOUSLY OWNED BY THE WASHINGTON METROPOLITAN AREA TRANSIT AUTHORITY.

LOTS ORIGINALLY ASSIGNED BY DISTRICT OF COLUMBIA OFFICE OF TAX AND REVENUE, REAL PROPERTY TAX ADMINISTRATION, MAPS AND TITLES SECTION ON FEBRUARY 22, 2013 AND REVISED IN 2013 AS TO LOTS 833 & 834, REVISED MARCH 13, 2017 AS TO LOTS 836, 837, 838 & 839, REVISED JUNE 18, 2019 AS TO LOTS 841 & 842, REVISED JUNE 24, 2019 AS TO LOTS 843, 844 & 845, REVISED APRIL 20, 2020 AS TO LOTS 846 THROUGH 866, REVISED PER SUBDIVISION BOOK 217 PG 157, DATED 11/18/20 FOR LOTS 4 THRU 48, REVISED PER A&T PLAT 3892-E DATED 2/8/21 AS TO LOTS 867 THRU 948 & 959 THRU 964, REVISED PER SUBDIVISION BOOK 218 PG 27, DATED 2/11/21 FOR LOT 49, REVISED PER A&T PLAT 3892-I DATED 6/3/21 AS TO LOTS 965 & 966, REVISED JANUARY 6, 2022 AS TO LOTS 967 & 968

PREPARED BY: AMT, LLC, CONSULTING ENGINEERS AND LAND SURVEYORS, 10 G STREET, NE, SUITE 430, WASHINGTON, DC 20002.
EXHIBIT LAST UPDATED: 01-14-22

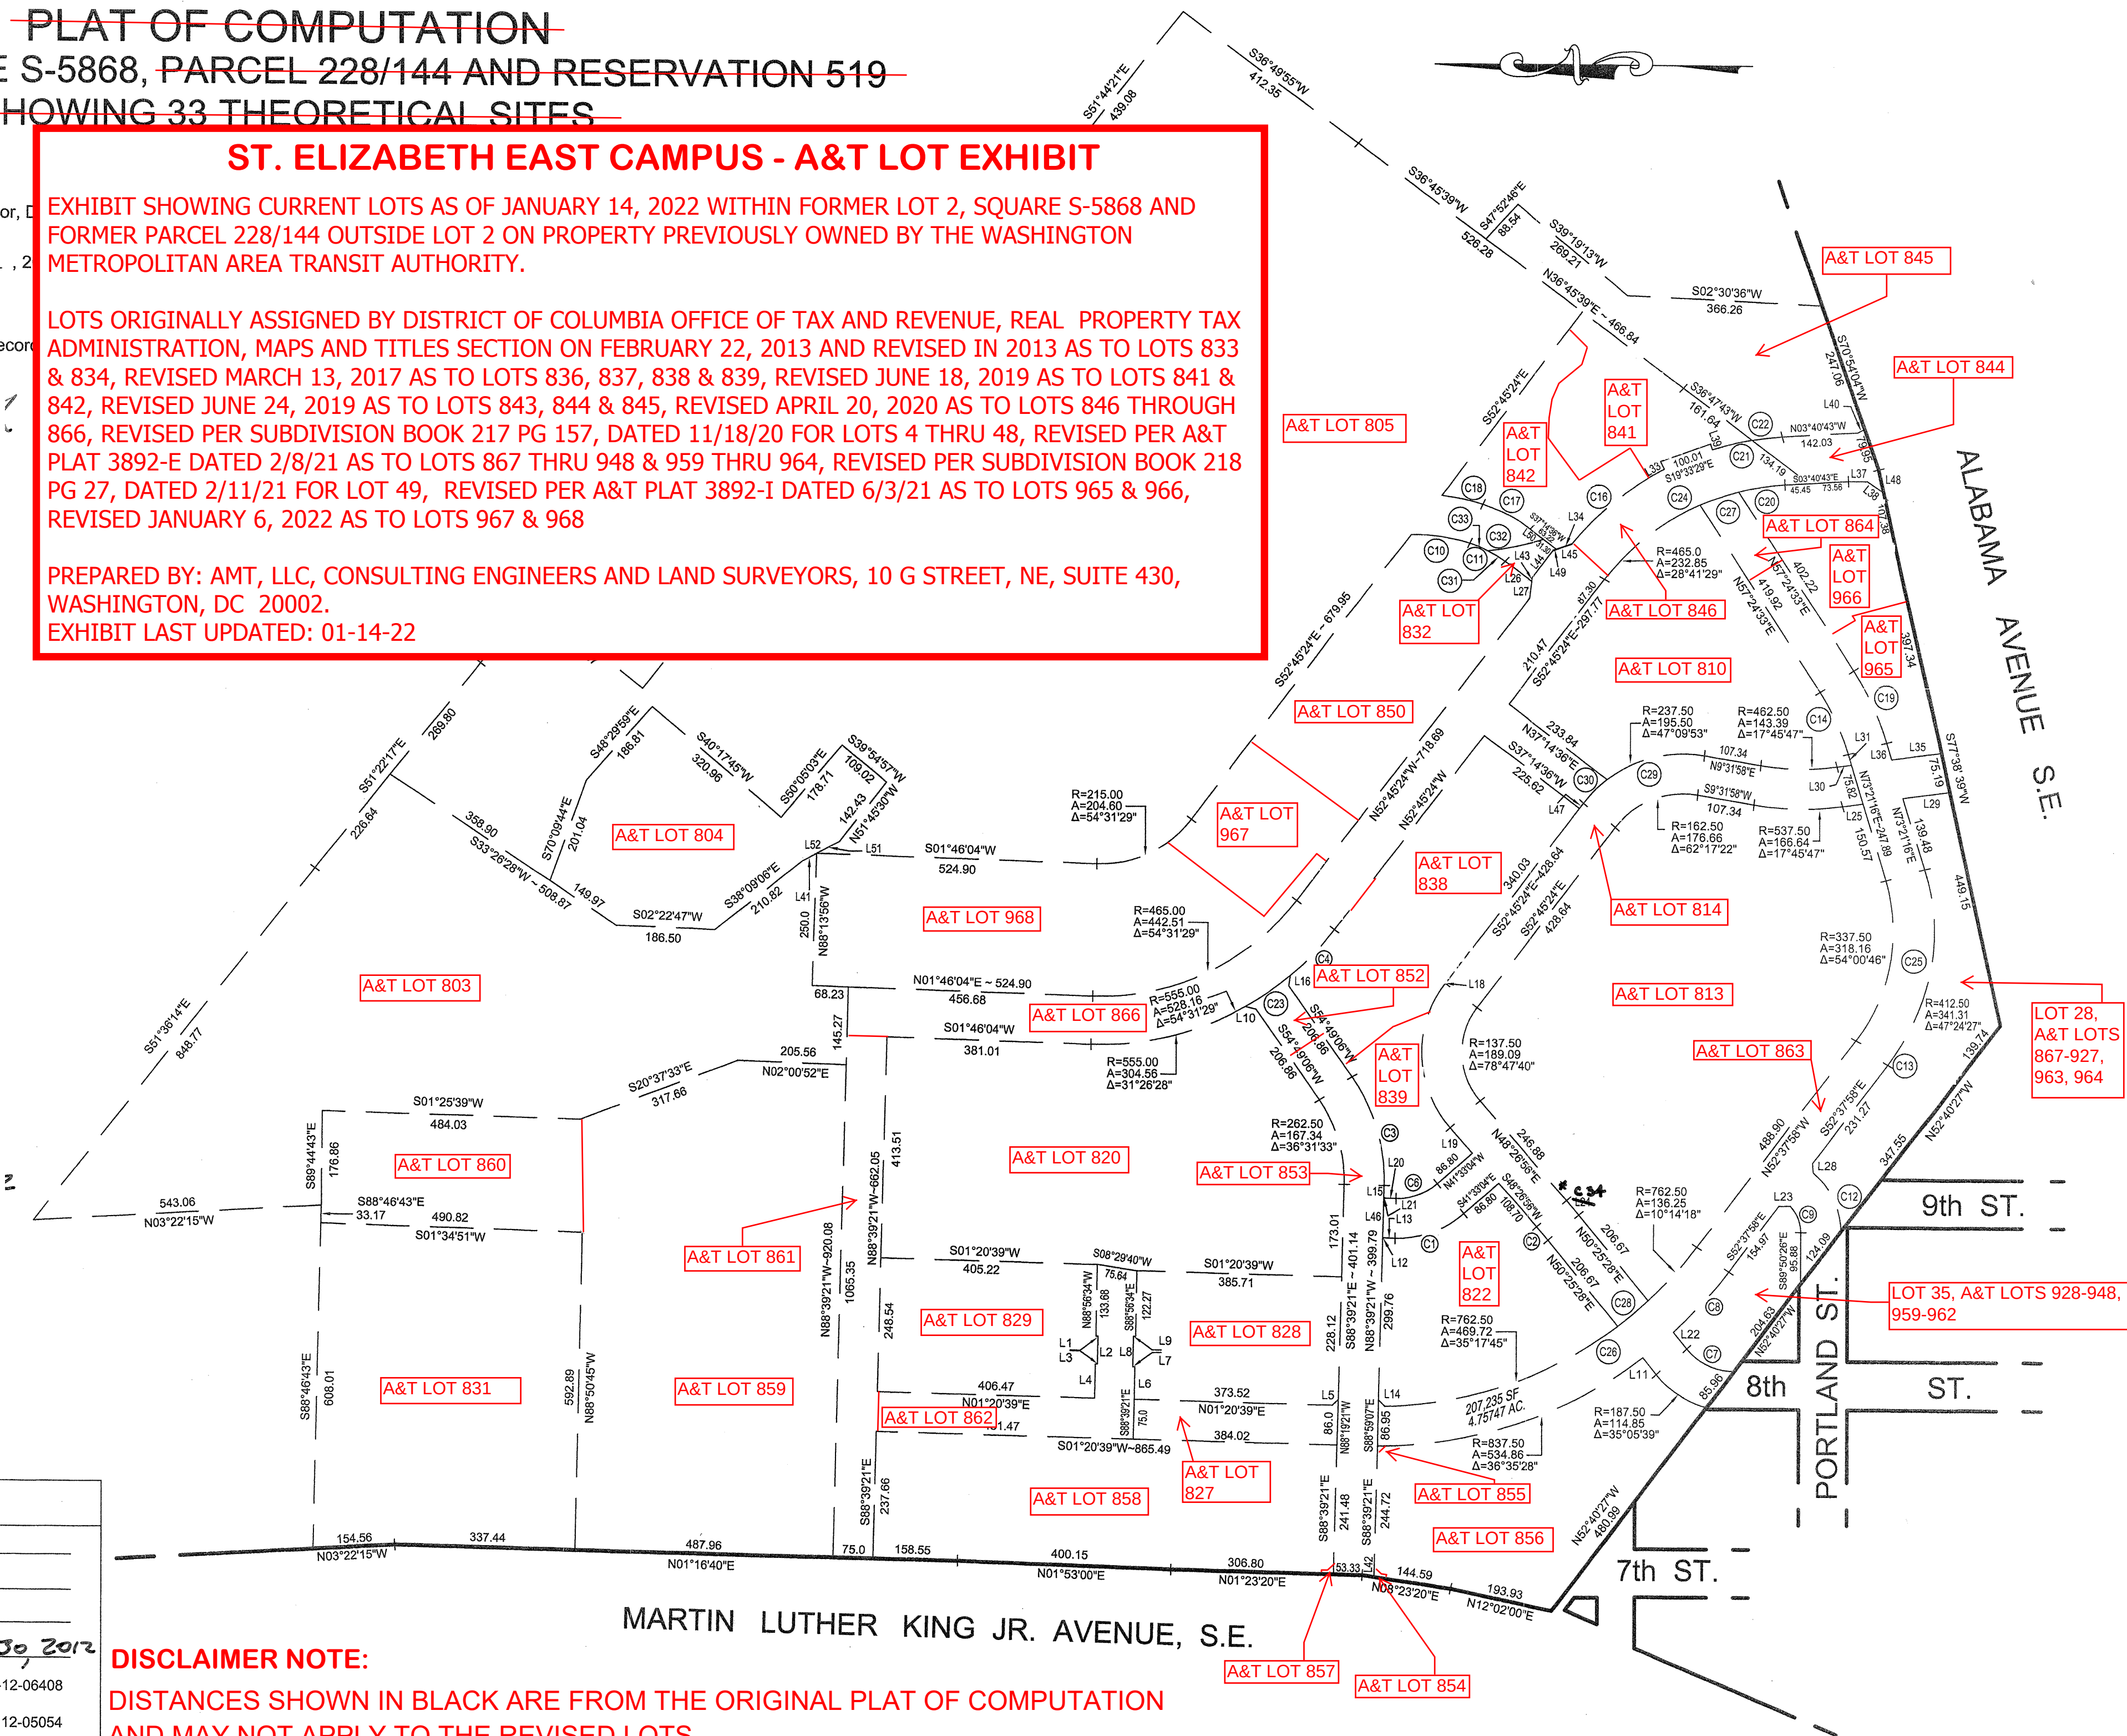

DISCLAIMER NOTE:

DISTANCES SHOWN IN BLACK ARE FROM THE ORIGINAL PLAT OF COMPUTATION AND MAY NOT APPLY TO THE REVISED LOTS.

SURVEYOR'S OFFICE, D.C.

Made for: CAREY SUMNER

Drawn by: L.E.S. Checked by: *PM*

Record and computations by: B. MYERS

Recorded at: 3:00 PM ON NOVEMBER 30, 2012

Recorded in Survey Book 204 Page 254 Receipt SR-12-06408

Scale: 1" = 200 feet

586 MAP
10371

S.O. File 12-05054

PAGE 1 OF 2